

Date: Tuesday, 11/22/2005 6:38:38 PM
 User: Linda Lacelle

Process Sheet

Customer	: CU-DAR001 Dart Helicopters Services	Drawing Name	: BUSHING
Job Number	: 24944		
Estimate Number	: 10897		
P.O. Number	:	Part Number	: D2618
This Issue	: 11/22/2005 S.O. No. : N/A	Drawing Number	: D2618 REV B1
Prsht Rev.	: NC	Project Number	: N/A
First Issue	: N/A Type : MACHINED PARTS	Drawing Revision	: B1
Previous Run	: N/A	Material	: N/A
Written By	: <u>See comment below</u>	Due Date	: 12/2/2005
Checked & Approved By	: <u>See comment below</u>	Qty:	50 Um: Each
Comment	: Est Rev:F Re-format 05-11-22 JLM		

Additional Product

Job Number:



Seq. #:	Machine Or Operation:	Description :
---------	-----------------------	---------------

1.0	MDELIRINR0500	Delrin Round Bar .50"
-----	---------------	-----------------------



Comment: Qty.: 0.2709 f(s)/Unit Total: 13.5450 f(s)

Delrin Round Bar .50" black

(MDELIRINR0500) 715637

Batch: M17992

fresh please
JML 05/11/27 58

2.0	HARDINGE	HARDINGE CNC LATHE SMALL
-----	----------	--------------------------



Comment: HARDINGE CNC LATHE SMALL

1-Turn as per Folio FA195 & Dwg D2618.

JML 05/11/27 58

2-Deburr

JML 05/11/27 58

3.0	QC2	INSPECT PARTS AS THEY COME OFF MACHINE
-----	-----	--



Comment: INSPECT PARTS AS THEY COME OFF MACHINE

JML 05/11/27 58

4.0	QC8	SECOND CHECK
-----	-----	--------------



Comment: SECOND CHECK

J.L 05.11.27 58

5.0	PACKAGING 1	PACKAGING RESOURCE #1
-----	-------------	-----------------------



Comment: PACKAGING RESOURCE #1

Identify and Stock

Location: 49

10 05/11/28 58

W/O:		WORK ORDER CHANGES					
DATE	STEP	PROCEDURE CHANGE	By	Date	Qty	Approval Chief Eng / Prod Mgr	Approval QC Inspector

Part No: _____ PAR #: _____ Fault Category: _____ NCR: Yes ☒ No ☐ DQA: ☒ ☐ Date: 05/11/29
 QA: N/C Closed: _____ Date: _____

NCR:		WORK ORDER NON-CONFORMANCE (NCR)						
DATE	STEP	Description of NC Section A	Corrective Action Section B			Verification Section C	Approval Chief Eng	Approval QC Inspector
			Initial Chief Eng	Action Description Chief Eng	Sign & Date			

NOTE: Date & initial all entries

Date: Tuesday, 11/22/2005 6:38:38 PM
User: Linda Lacelle

Process Sheet

Customer: CU-DAR001 Dart Helicopters Services

Drawing Name: BUSHING

Job Number: 24944

Part Number: D2618

Job Number:



Seq. #:

Machine Or Operation:

Description :

6.0

DC

DOCUMENT CONTROL



Comment: DOCUMENT CONTROL
Inspection Level 21

LP 05/11/27 (58)

Job Completion



W/O:		WORK ORDER CHANGES						
DATE	STEP	PROCEDURE CHANGE	By	Date	Qty	Approval Chief Eng / Prod Mgr	Approval QC Inspector	

Part No: _____ PAR #: _____ Fault Category: _____ NCR: Yes No DQA: _____ Date: _____

QA: N/C Closed: _____ Date: _____


NCR:		WORK ORDER NON-CONFORMANCE (NCR)						
DATE	STEP	Description of NC Section A	Corrective Action Section B			Verification Section C	Approval Chief Eng	Approval QC Inspector
			Initial Chief Eng	Action Description Chief Eng	Sign & Date			

NOTE: Date & initial all entries



DESIGN BW	DRAWN BY KE	DART AEROSPACE LTD VICTORIA INTERNATIONAL AIRPORT, CANADA	
CHECKED BW	APPROVED BW	DRAWING NO. D2618	REV. B SHEET 1 OF 1
DATE 96:10:30		TITLE BUSHING	SCALE 1:1
B	97.05.09	3.125 WAS 1.625, .313 WAS .375	
B1	04.06.03	CHANGE DIM FOR BETTER FIT	

RELEASED
91/05/13 DS

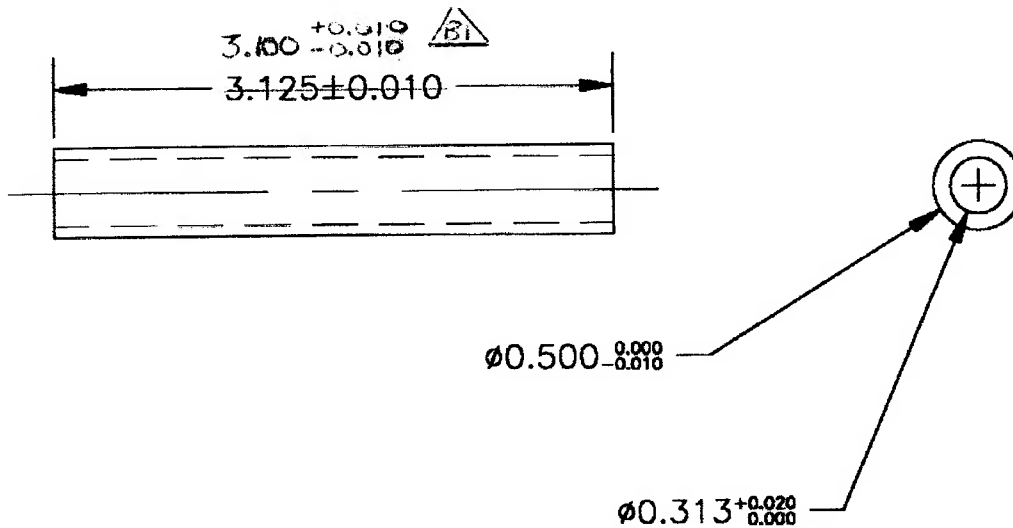

MATERIAL: DELRIN OR TEFLON OR NYLON

